

5/31

DART AEROSPACE LTD	Work Order:	23821
Description: 350 Skidtube Web	Part Number:	D2739
Drawing: D2739 Rev B	Qty:	2
		Page 1 of 1

Step	Location	Procedure	By	Date	Qty
1	DC	Issue Traveller RF 03.05.12 DWG NOT REQUIRED	RF	05.07.15	2
2	LG	Pick: Qty Part Number Description Batch 1 D2600-5 Web B12433	PMC	05-05-11	2
3	LG	Cut D2600-5 to length as per Dwg D2739.	PMC	05-08-11	2
4	LG	Drill pilot holes in web using drilling Jig DT8162 as per Dwg D2739	PMC	05-08-11	2
5	LG	Use uni-bit to open holes to finish size as per Dwg D2739.	PMC	05-05-11	2
6	LG	Bevel Fwd ends (1" max) of extrusion and Deburr holes and ends.	PMC	05-08-11	2
7	FP	Acid Etch and Alodine per QSI 005 4.1	ML	05 08 17	2
8	LG	Use a red or black lead-free paint pen to write the part number and batch number in the middle of each web.			
9	QC5	Inspect for completeness on the W/O	J	05-08-25	2
10	LG	Identify and Stock using a lead free paint pen	PMC	05-9-7	2
11	AC	Cost / part 45.49	J	05-09-08	2
12	DC	Close W/O 27.39 Inspect Level 21	D	05/09/08	2

Rev	Date	Change	Revised By	Approved
A	98.09.09	New Issue	DS/CP	
B	99.01.04	Drawing to Rev. B	DM	
C	02.11.28	Reformat	KJ / RF RF	

RELEASED
02/11/29 RF

W/O:		WORK ORDER CHANGES					
DATE	STEP	PROCEDURE CHANGE	By	Date	Qty	Approval Mfg / Design Mgr	Approval QC Inspector

NCR:		WORK ORDER NON-CONFORMANCE (NCR)						
DATE	STEP	Description of NC Section A	Corrective Action Section B			Verification Section C	Approval Design Mgr	Approval QC Inspector
			Initial Design Mgr	Action Description Design Mgr	Sign & Date			



Part No: _____ PAR #: _____ Fault Category: _____ NCR: Yes ☒ No ☐ DQA:  Date: 05/09/08

NOTE: Date & initial all entries

QA: N/C Closed: _____ Date: _____



DESIGN	DRAWN BY	DART AEROSPACE USA, INC.	REV. B
<i>[Signature]</i>	<i>[Signature]</i>	BELLEVUE, WA	
CHECKED <i>[Signature]</i>	APPROVED <i>[Signature]</i>	DRAWING NO. D2739	SHEET 1 OF 1
DATE 98.11.18		TITLE WEB	SCALE 1:15
A	98.04.16	NEW ISSUE	
B	98.11.18	CHANGE HOLES FOR COMPATABILITY WITH AIRCRUISER FLOATS	

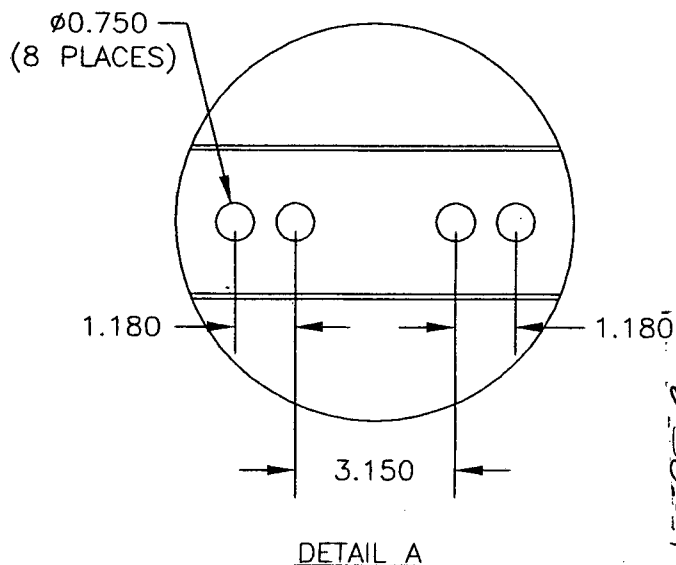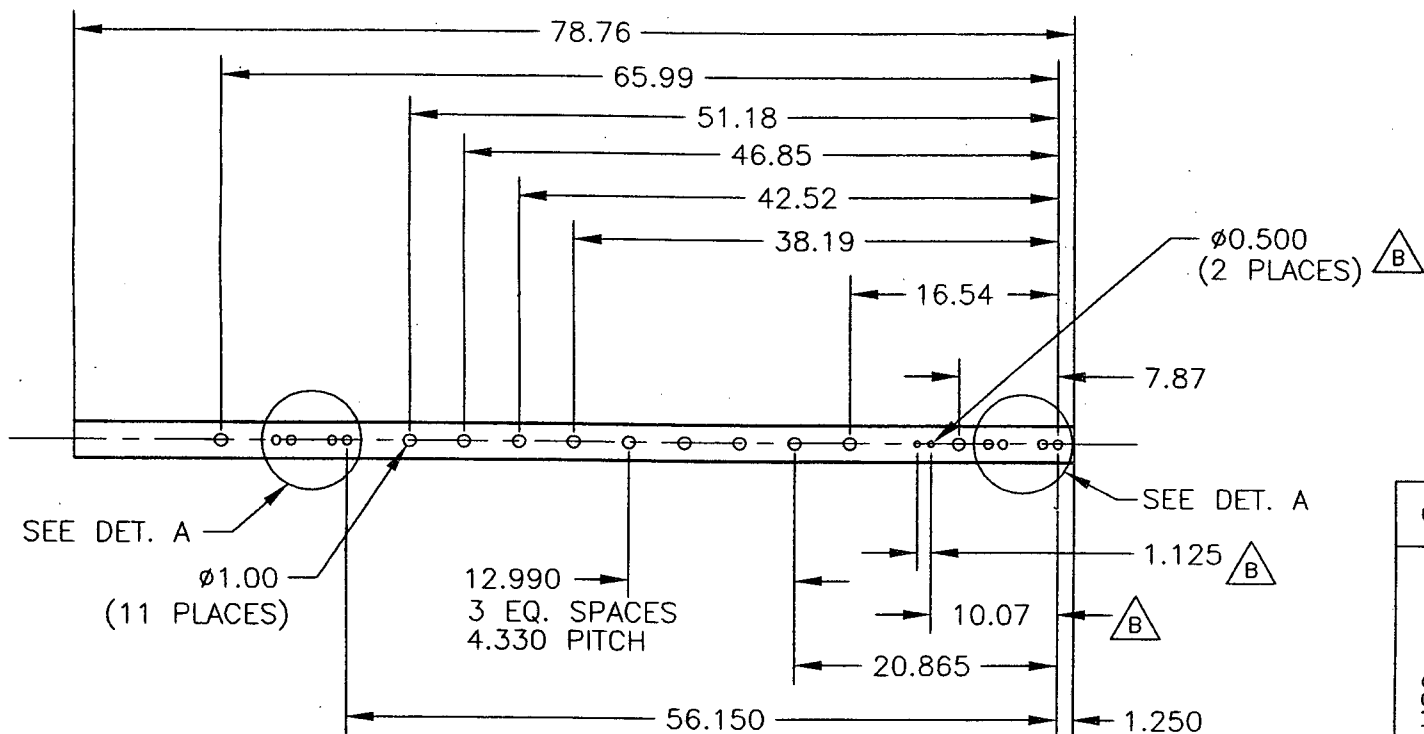

MAKE FROM D2600-5 EXTRUSION
FINISH: ACID ETCH, ALODINE PER DART QSI 005 4.1
TOLERANCES ARE PER DART QSI 018
UNLESS OTHERWISE NOTED

SHOP COPY
RETURN TO
ENGINEERING

STAMPED COPY

23821

RELEASED
98.12.16 AS

Job Costing Report

Dart Aerospace Ltd.
Hawkesbury

Jul 14, 2005
03:52 pm

Work Order No : 0023821
Project Name : D2739
Project For : WK531
Work Order Type : Main
Main WO Number :
House Part Number : D2739
Description : 350 I Beam
Manufactured : Yes
Amount Req'd : 2
Amount Done : 0
Start Date : 07-14-05
Est Finish Date : 08-05-05
Act Finish Date :
Drawings Req'd : No
Ok for Approval :
Approval Rec'd :

Department Code:
Burden Flags : NNNNNNNN
WO Status : Open
Invoice State : Not Invoiced
Invoice Date :
Invoice Number :
Invoice Amount : 0.00
Order Entry No :
OE Value : 0.00
Est Mark Up : 0.000%
Actual Mark Up : 0.000%
\$0 Posted to Finished Goods

	Estimated	Actual	Var. %	Posted	To Post
Material Cost :	0.00	0.00	0.00	0.00	0.00
Engineering Hours :	0.00	0.00	0.00		
Engineering Cost :	0.00	0.00	0.00	0.00	0.00
Production Hours :	0.00	0.00	0.00		
Production Cost :	0.00	0.00	0.00	0.00	0.00
Packaging Hours :	0.00	0.00	0.00		
Packaging Cost :	0.00	0.00	0.00	0.00	0.00
OverHead Hours :	0.00	0.00	0.00		
OverHead Cost :	0.00	0.00	0.00	0.00	0.00
CNC Hours :	0.00	0.00	0.00		
CNC :	0.00	0.00	0.00	0.00	0.00
Misc. Hours :	0.00	0.00	0.00		
Misc. :	0.00	0.00	0.00	0.00	0.00
Burden :	0.00	0.00	0.00		
Total Cost :	0.00	0.00	0.00		
Mark up :	0.000	0.000			
Selling Cost :	0.00	0.00			

	Estimated	Actual
Labour Hrs/Amount Done :	0.00	0.00
Profits/(Loss) :	0.00	0.00